




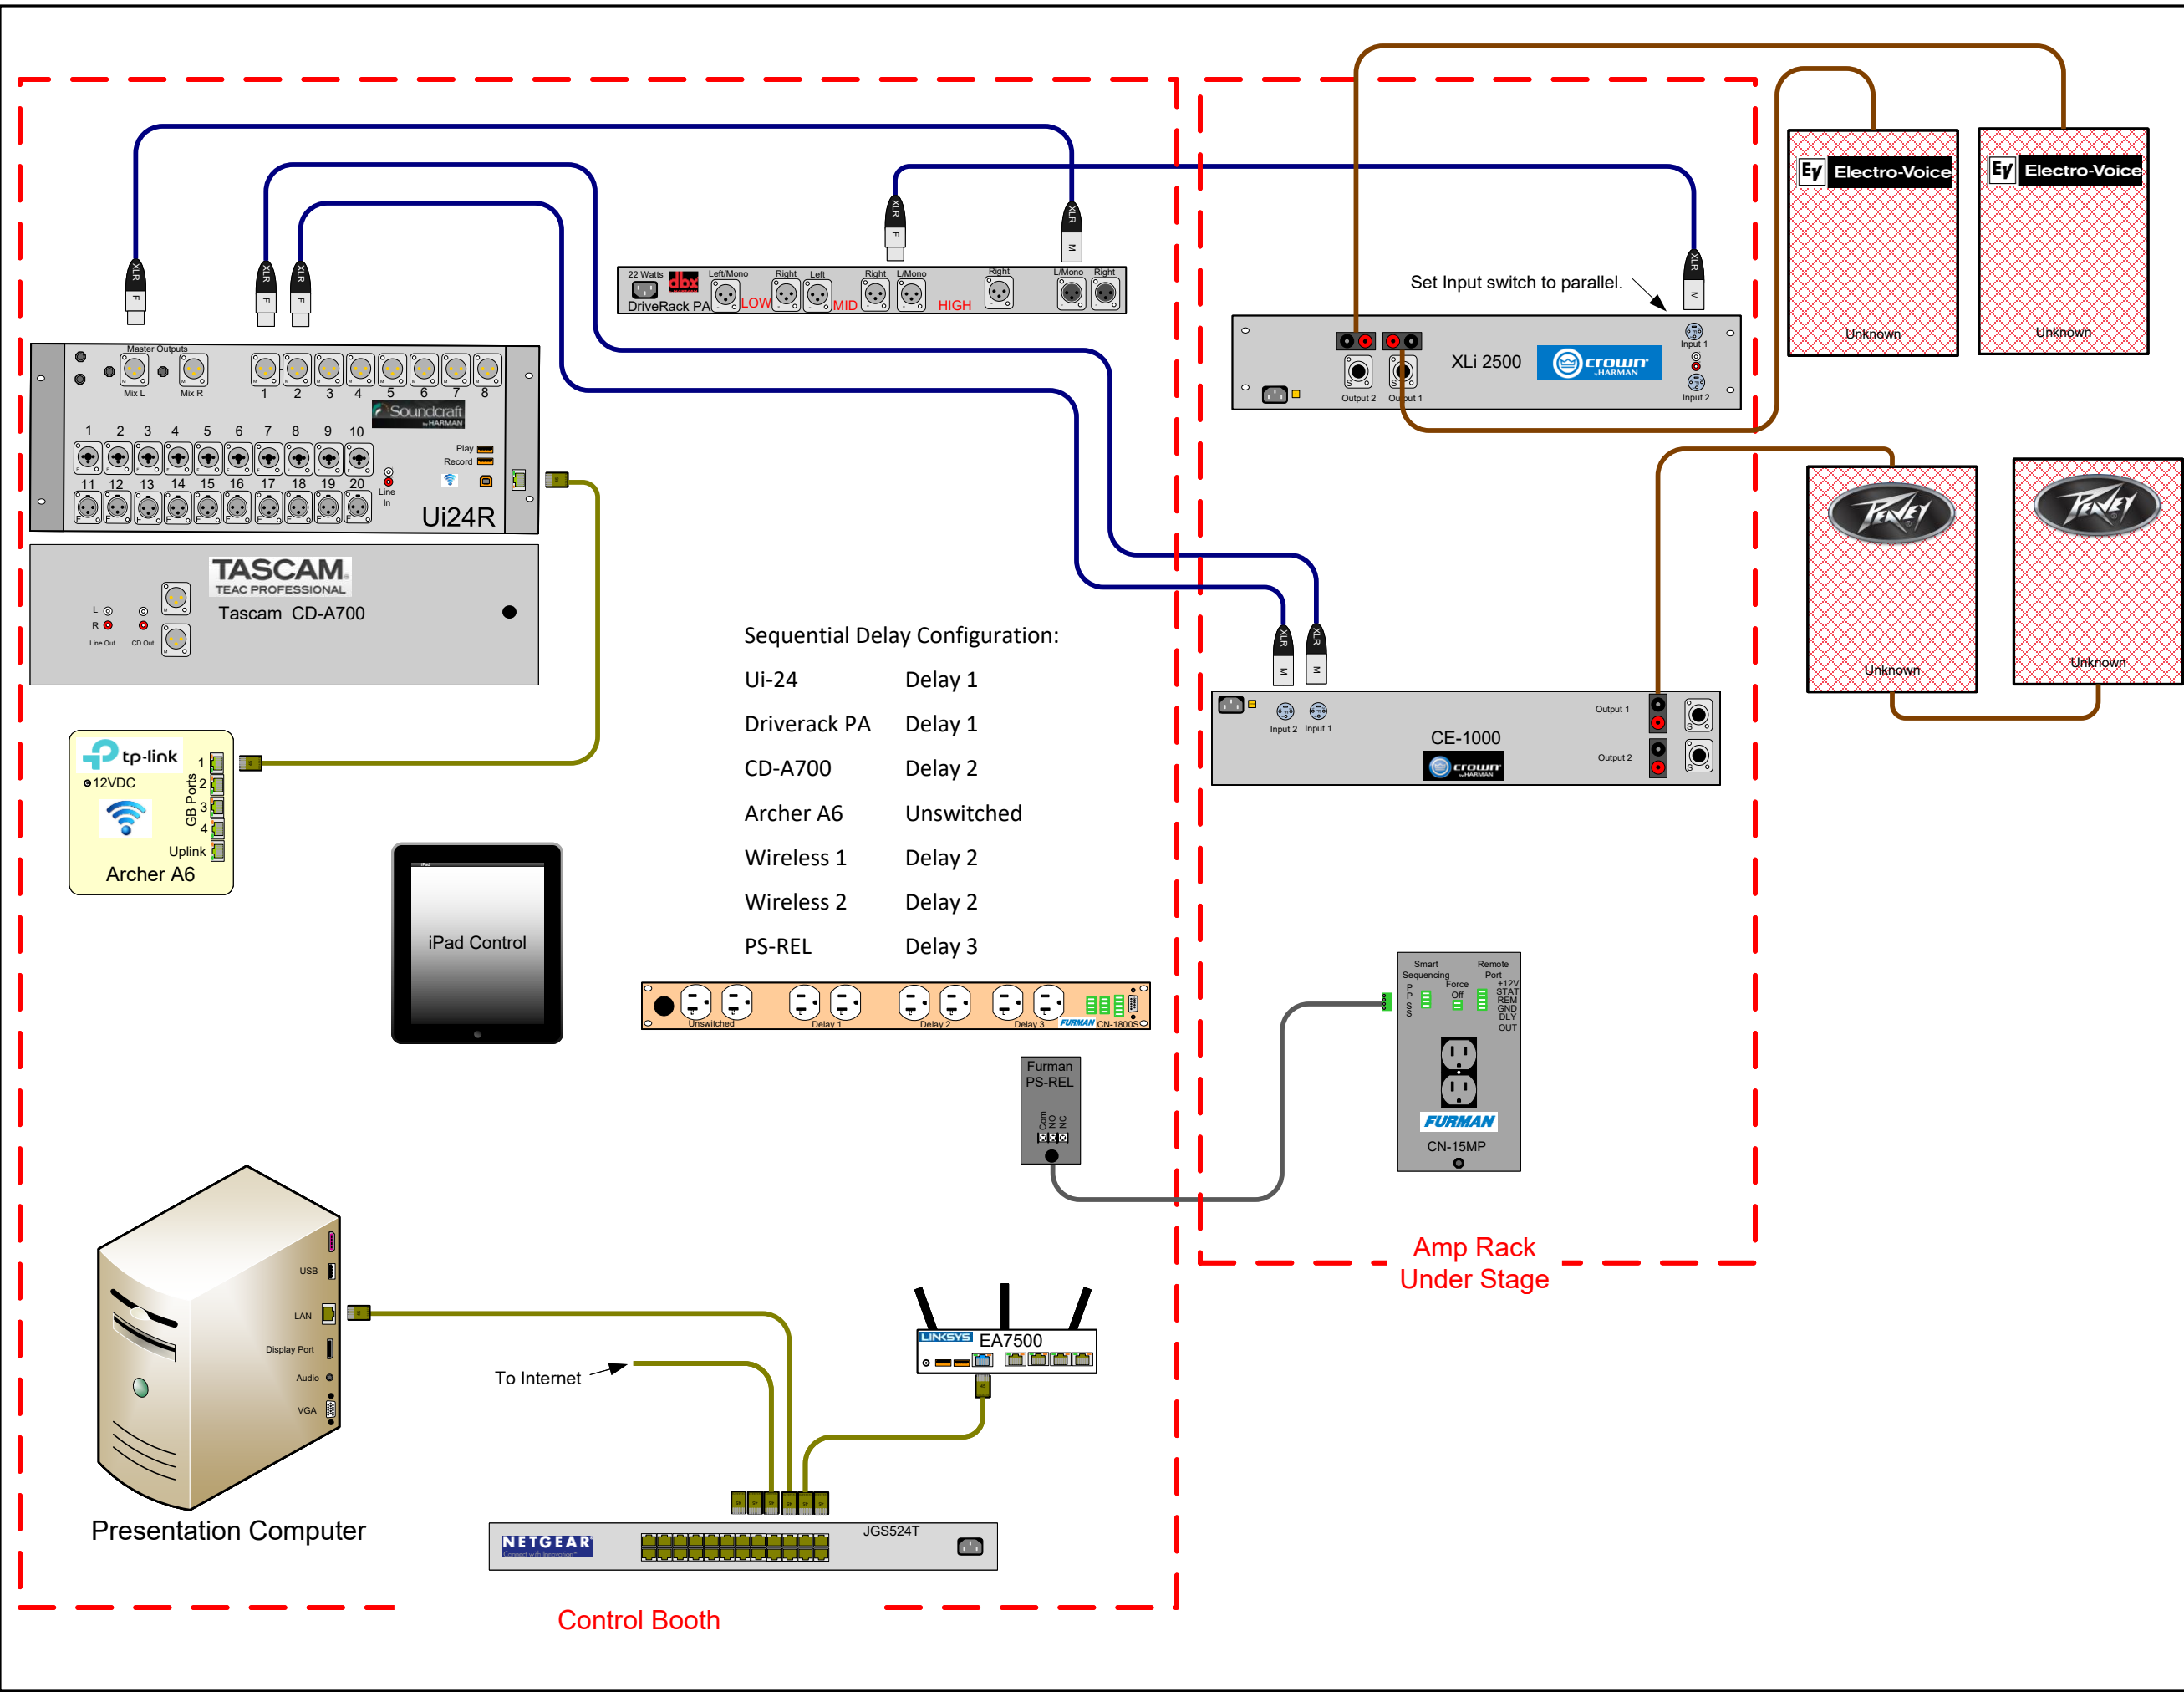

**SOUND CONCEPTS LLC**

1233 Castle Dr. Ste A5 Mason, Oh 45040  
513-703-0147  
customerservice@soundconceptsllc.com  
www.soundconceptsllc.com

**Wire Color Legend**

| Color        | AC | AC Line           |
|--------------|----|-------------------|
| Blue         | B  | Audio, Balanced   |
| Purple       | U  | Audio, Unbalanced |
| Brown        | S  | Speaker           |
| Teal         | DA | Digital Audio     |
| Yellow       | E  | Data              |
| Green        | DS | Data Shielded     |
| Light Green  |    | Ground Circuit    |
| Light Blue   | BL | BLU Link          |
| Pink         | C  | Co-Ax             |
| Red          | DC | DC Power          |
| Dark Green   | CO | Serial            |
| Orange       | U  | USB               |
| Light Orange | F  | Fiber             |
| Pink         | H  | HDMI - DVI        |
| Light Blue   | HD | As Marked         |
| Grey         | A  | As Marked         |

Proprietary & Confidential  
Property of Sound Concepts LLC  
Copyright 2025

CUSTOMER

**Beacon of Christ**

Address

PROJECT

**Audio System**

| Proj #       | Dwg #          |
|--------------|----------------|
| <b>50937</b> | <b>50937-C</b> |
| Date         | Revision       |
| 11-24-25     | 2              |
| DRAWN BY     | PAGE           |
| J Murphy     | 1 OF 1         |