




SOUND CONCEPTS LLC
 1233 Castle Dr. Ste A5 Mason, Oh 45040
 513-703-0147
 customerservice@soundconceptsllc.com
 www.soundconceptsllc.com

**Incomplete
As Built**

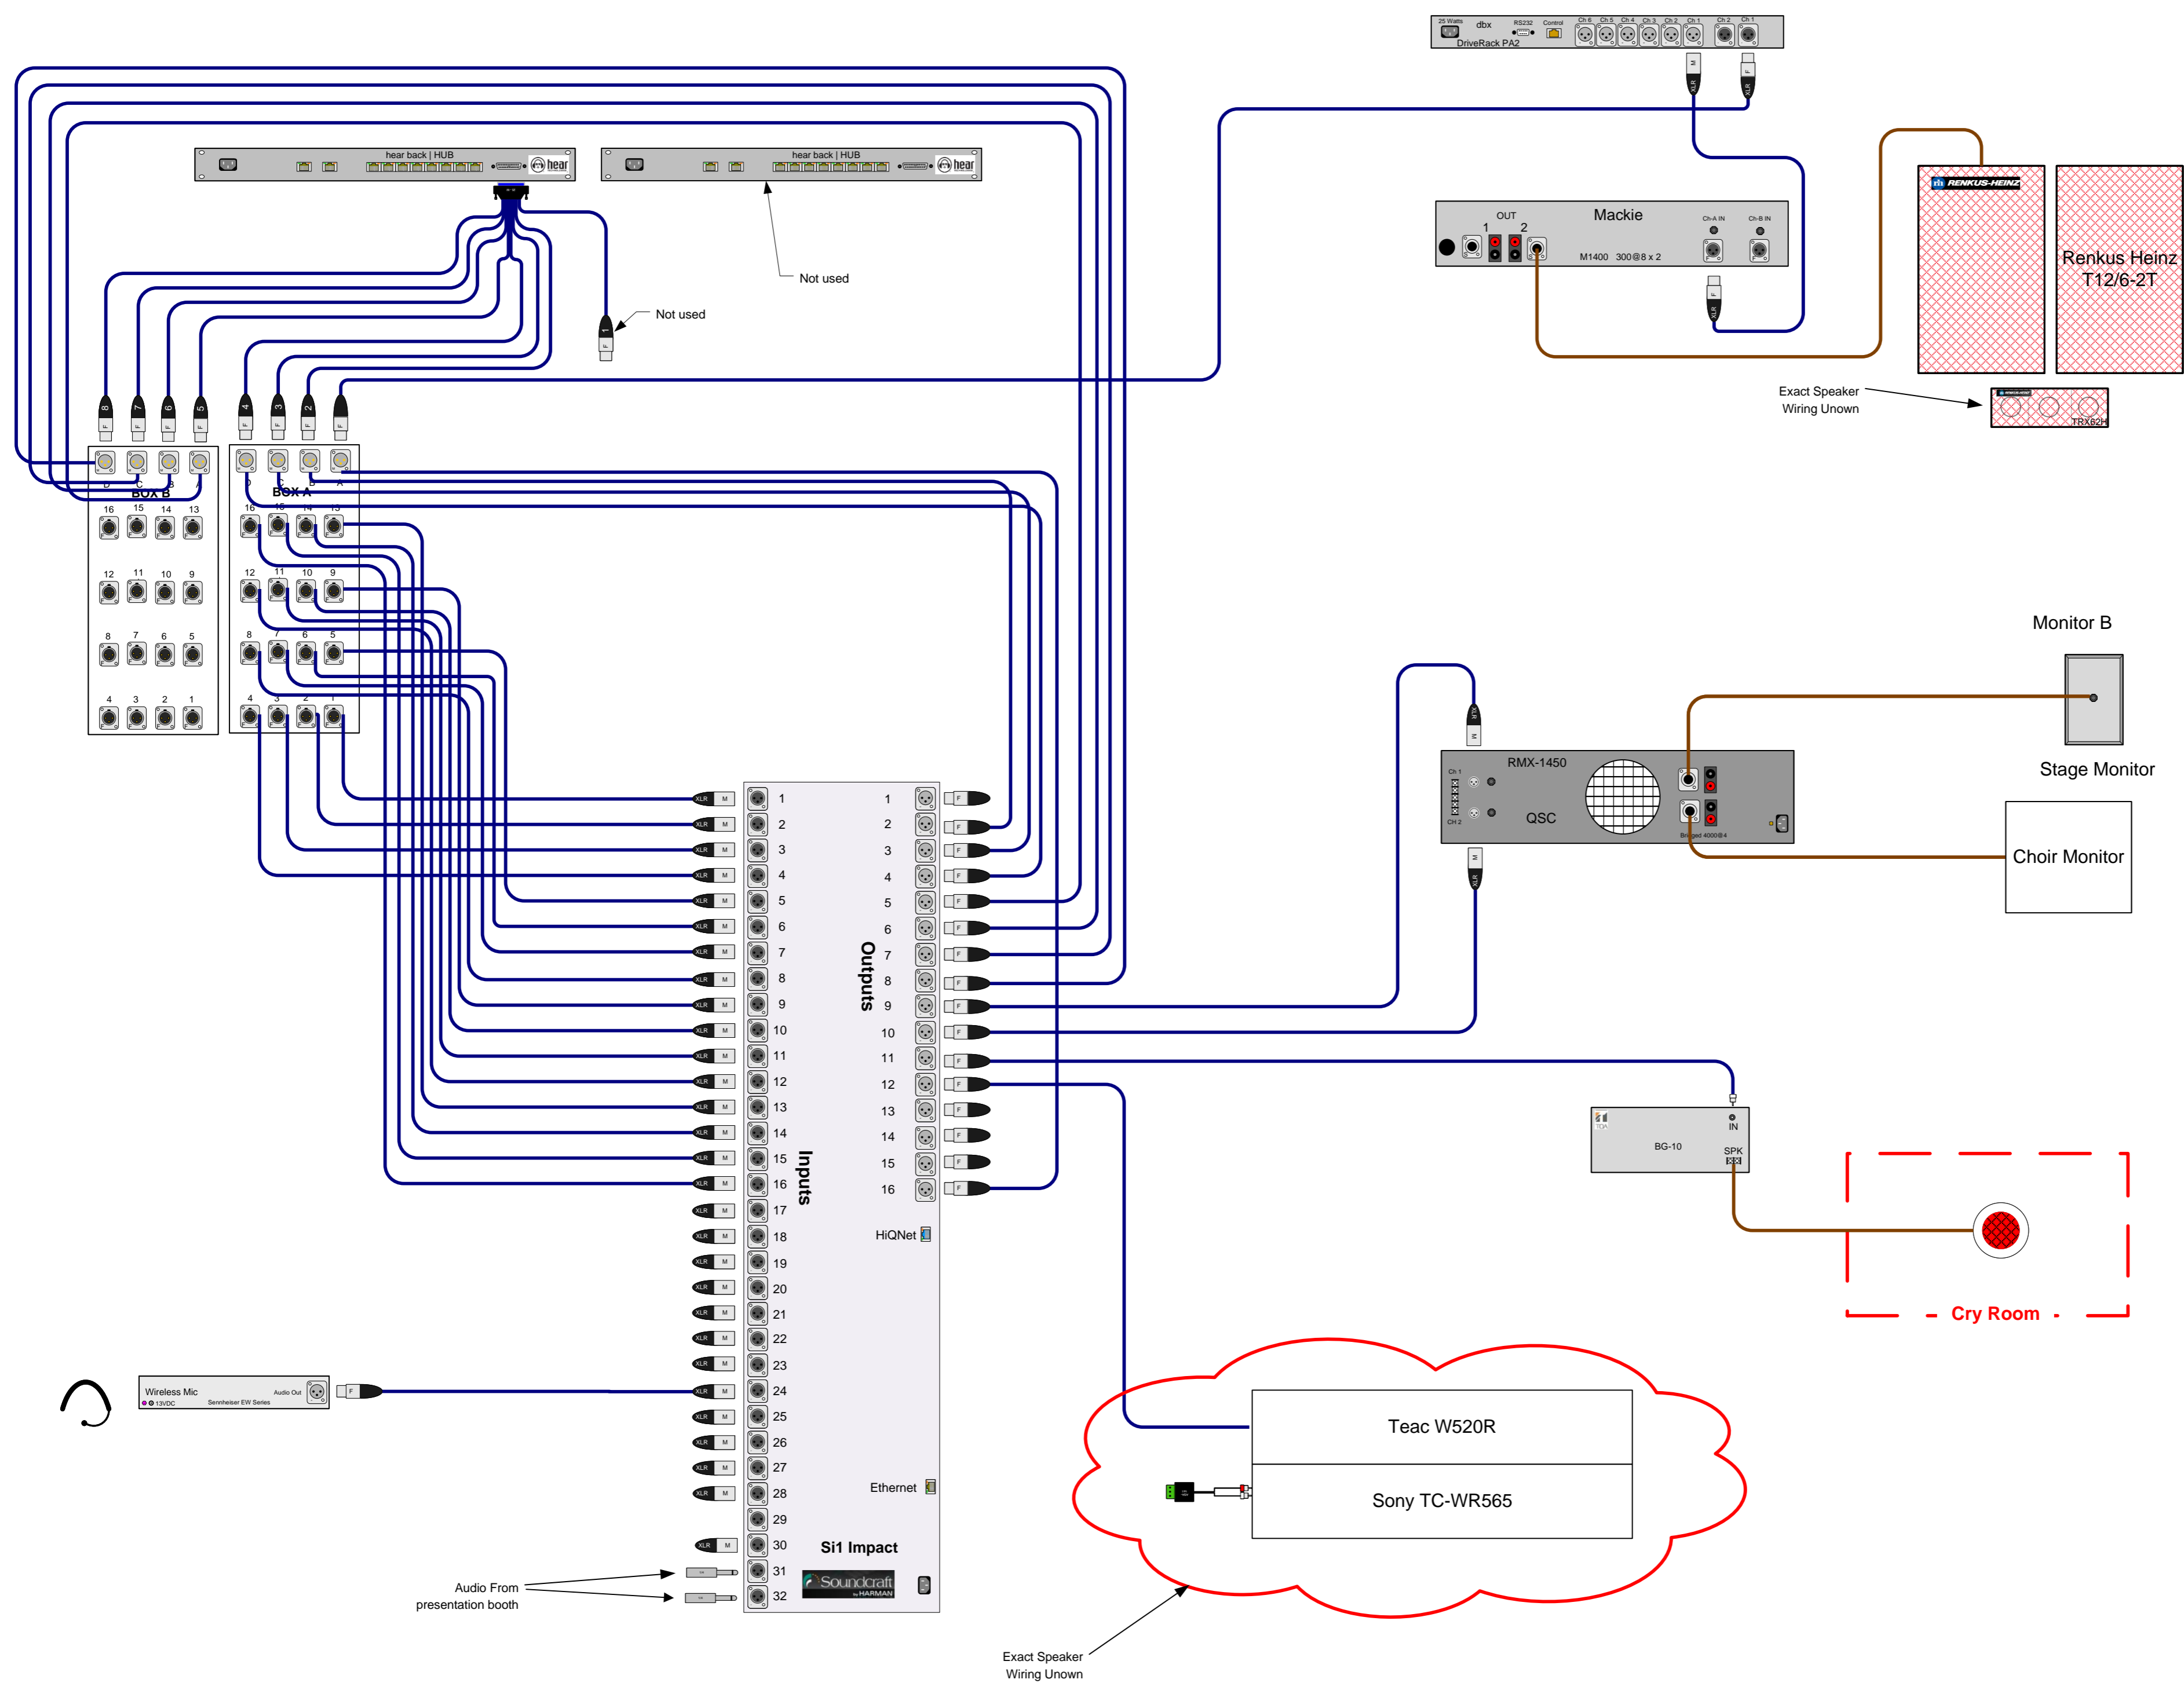

Wire Color Legend

AC	AC Line
B	Audio, Balanced
U	Audio, Unbalanced
S	Speaker
DA	Digital Audio
E	Data
—	Ground Circuit
BL	BLU Link
C	Co-Ax
DC	DC Power
CO	Serial
DM	Digital Media 8G
F	Fiber
H	HDMI - DVI
A	As Marked

Proprietary & Confidential
 Property of Sound Concepts LLC
 Copyright 2022

Customer	
Faith Lutheran	
Project	
Sanctuary Schematics	
PROJ #	DWG #
50753	50753
DATE	Revision
5-25-2022	0
DRAWN BY	PAGE
J Murphy	1 OF 1