



SOUND CONCEPTS LLC


1233 Castle Dr. Ste A5 Mason, Oh 45040
513-703-0147

customerservice@soundconceptsllc.com
www.soundconceptsllc.com

As Built

Wire Color Legend

- AC Line
- Audio, Balanced
- Audio, Unbalanced
- Speaker
- Digital Audio
- Data
- Data Shielded
- Ground Circuit
- BLU Link
- Co-Ax
- DC Power
- Serial
- USB
- Fiber
- HDMI - DVI
- As Marked

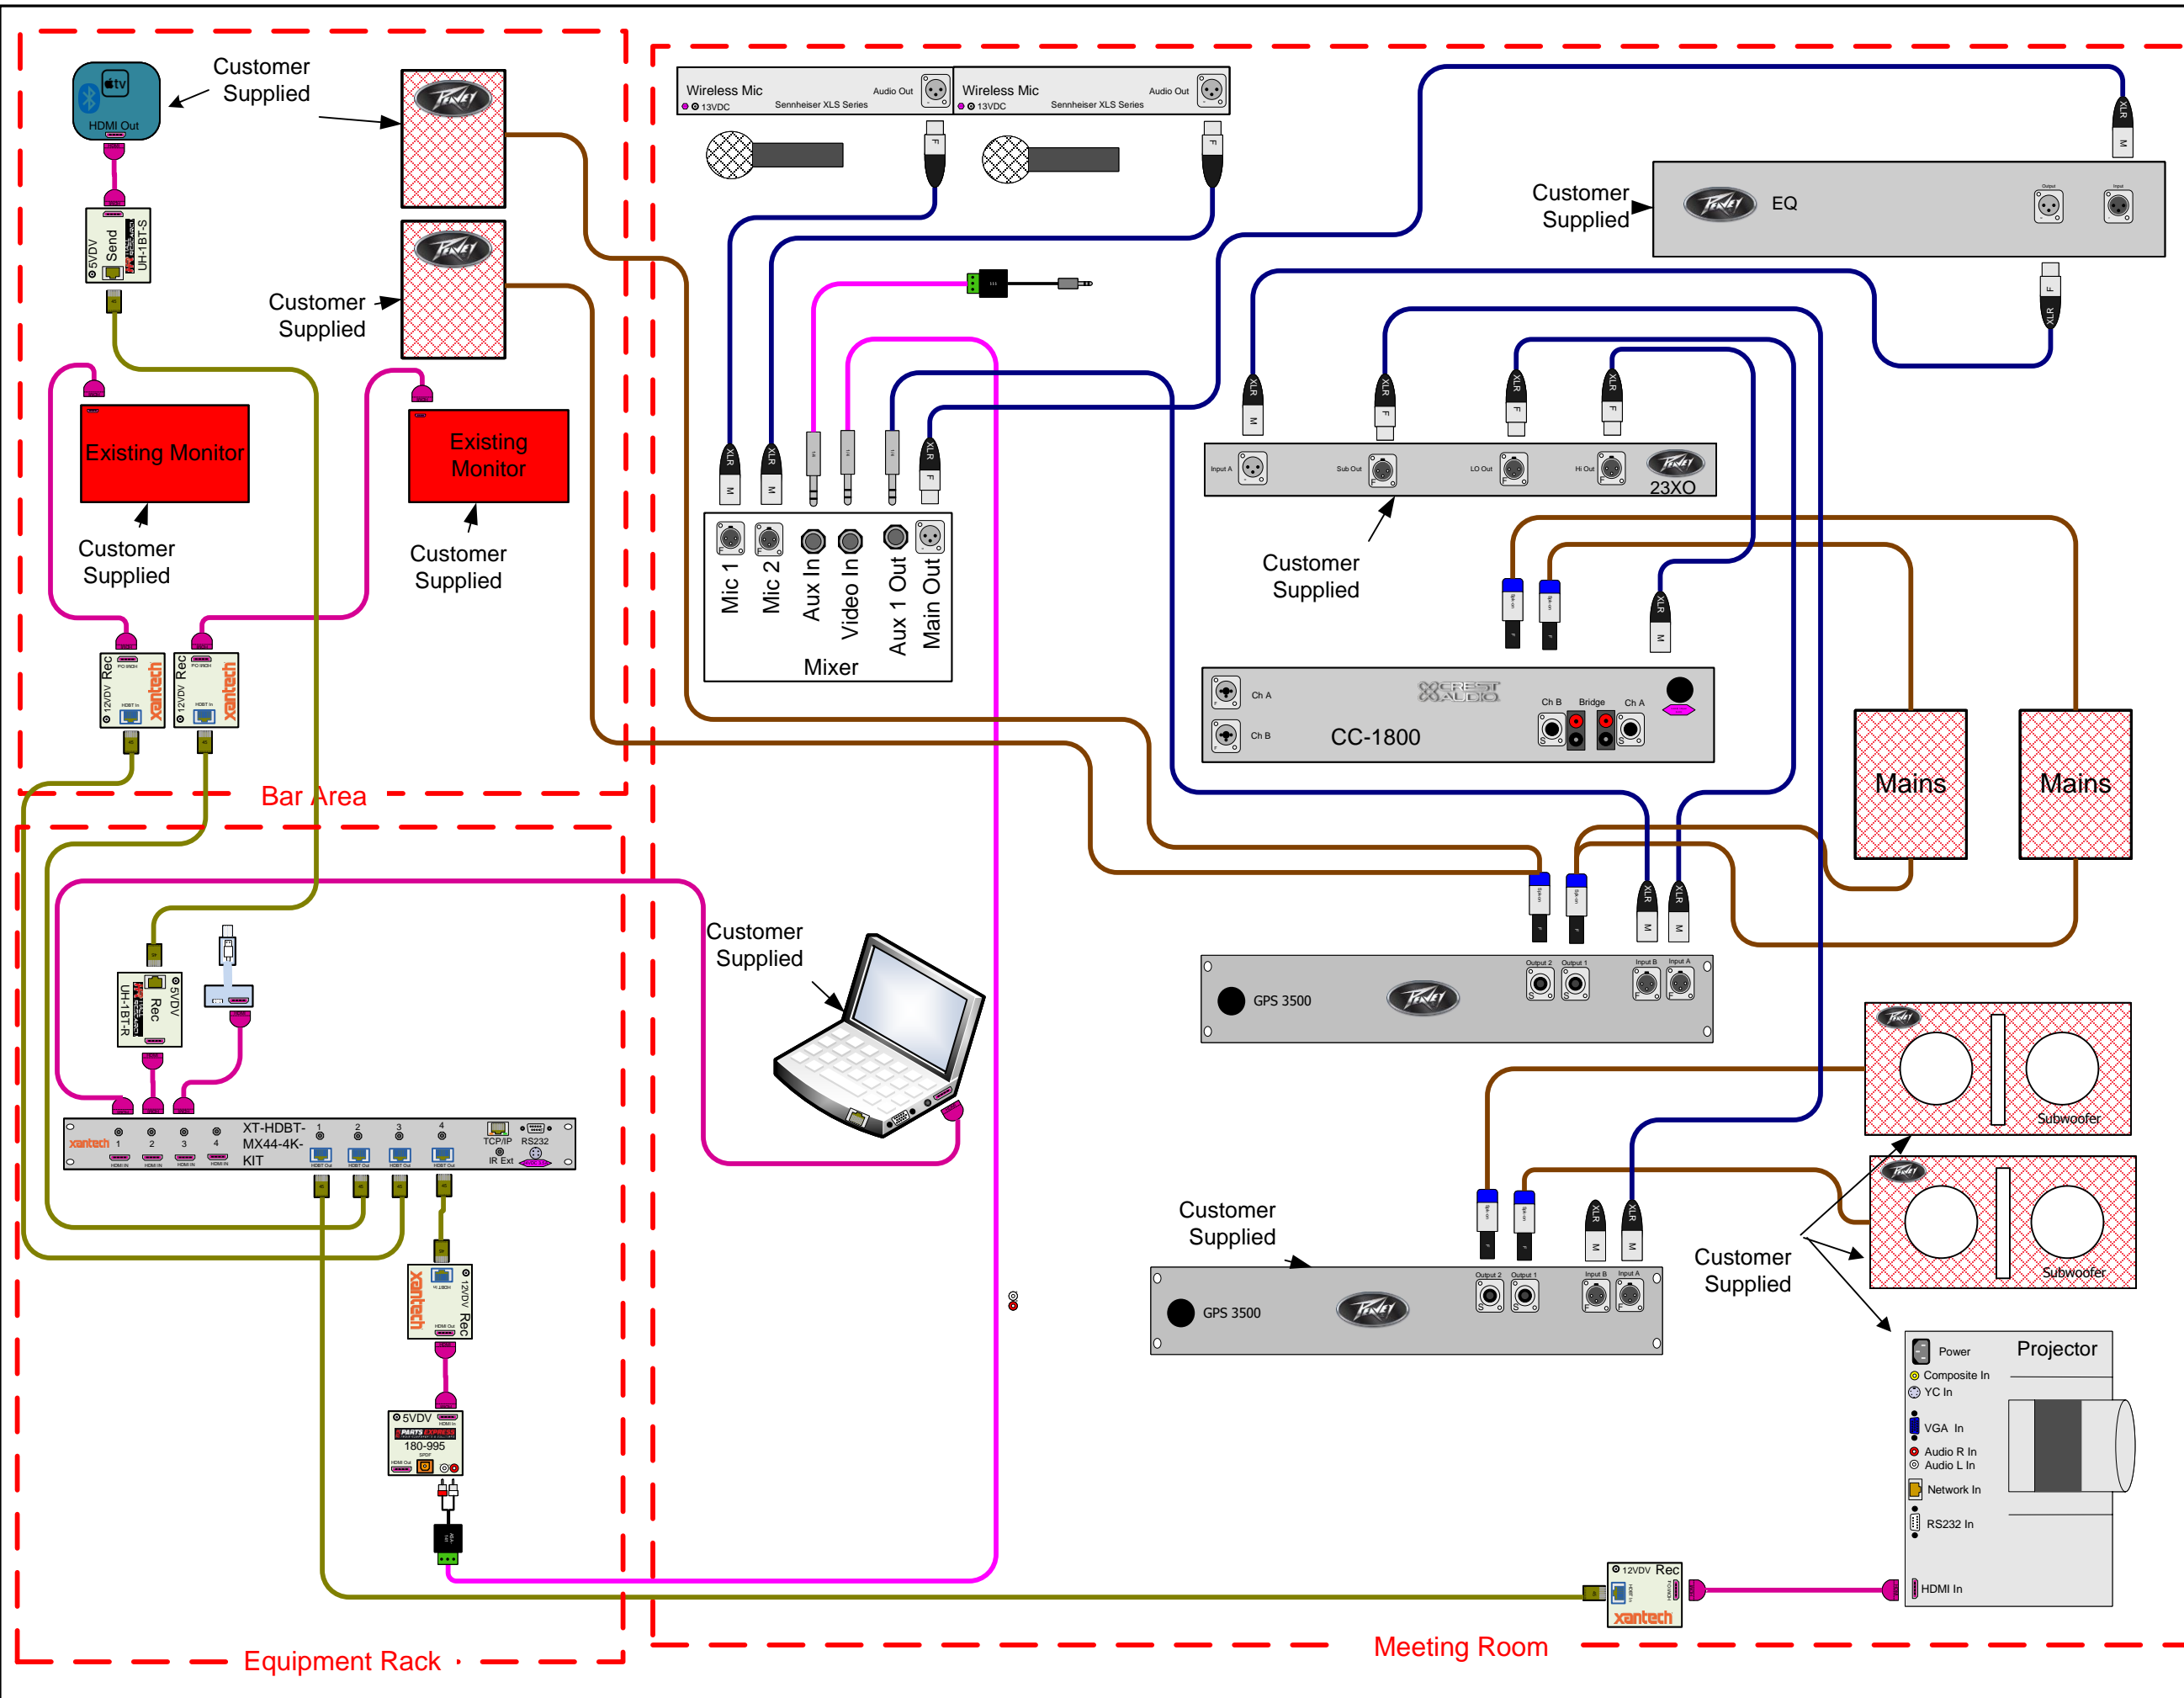

Proprietary & Confidential
Property of Sound Concepts LLC
Copyright 2022

CUSTOMER	
Nelson Stark	
Address	
PROJECT	
Bar/Banquet	
Proj #	Dwg #
50960	As Built
Date	Revision
1-27-2022	0
DRAWN BY	PAGE
J Murphy	1 OF 1