


**Wire Color Legend**

AC	AC Line
B	Audio, Balanced
U	Audio, Unbalanced
S	Speaker
DA	Digital Audio
E	Data
DS	Data Shielded
	Ground Circuit
BL	BLU Link
C	Co-Ax
DC	DC Power
CO	Serial
U	USB
F	Fiber
H	HDMI - DVI
HD	As Marked
A	As Marked

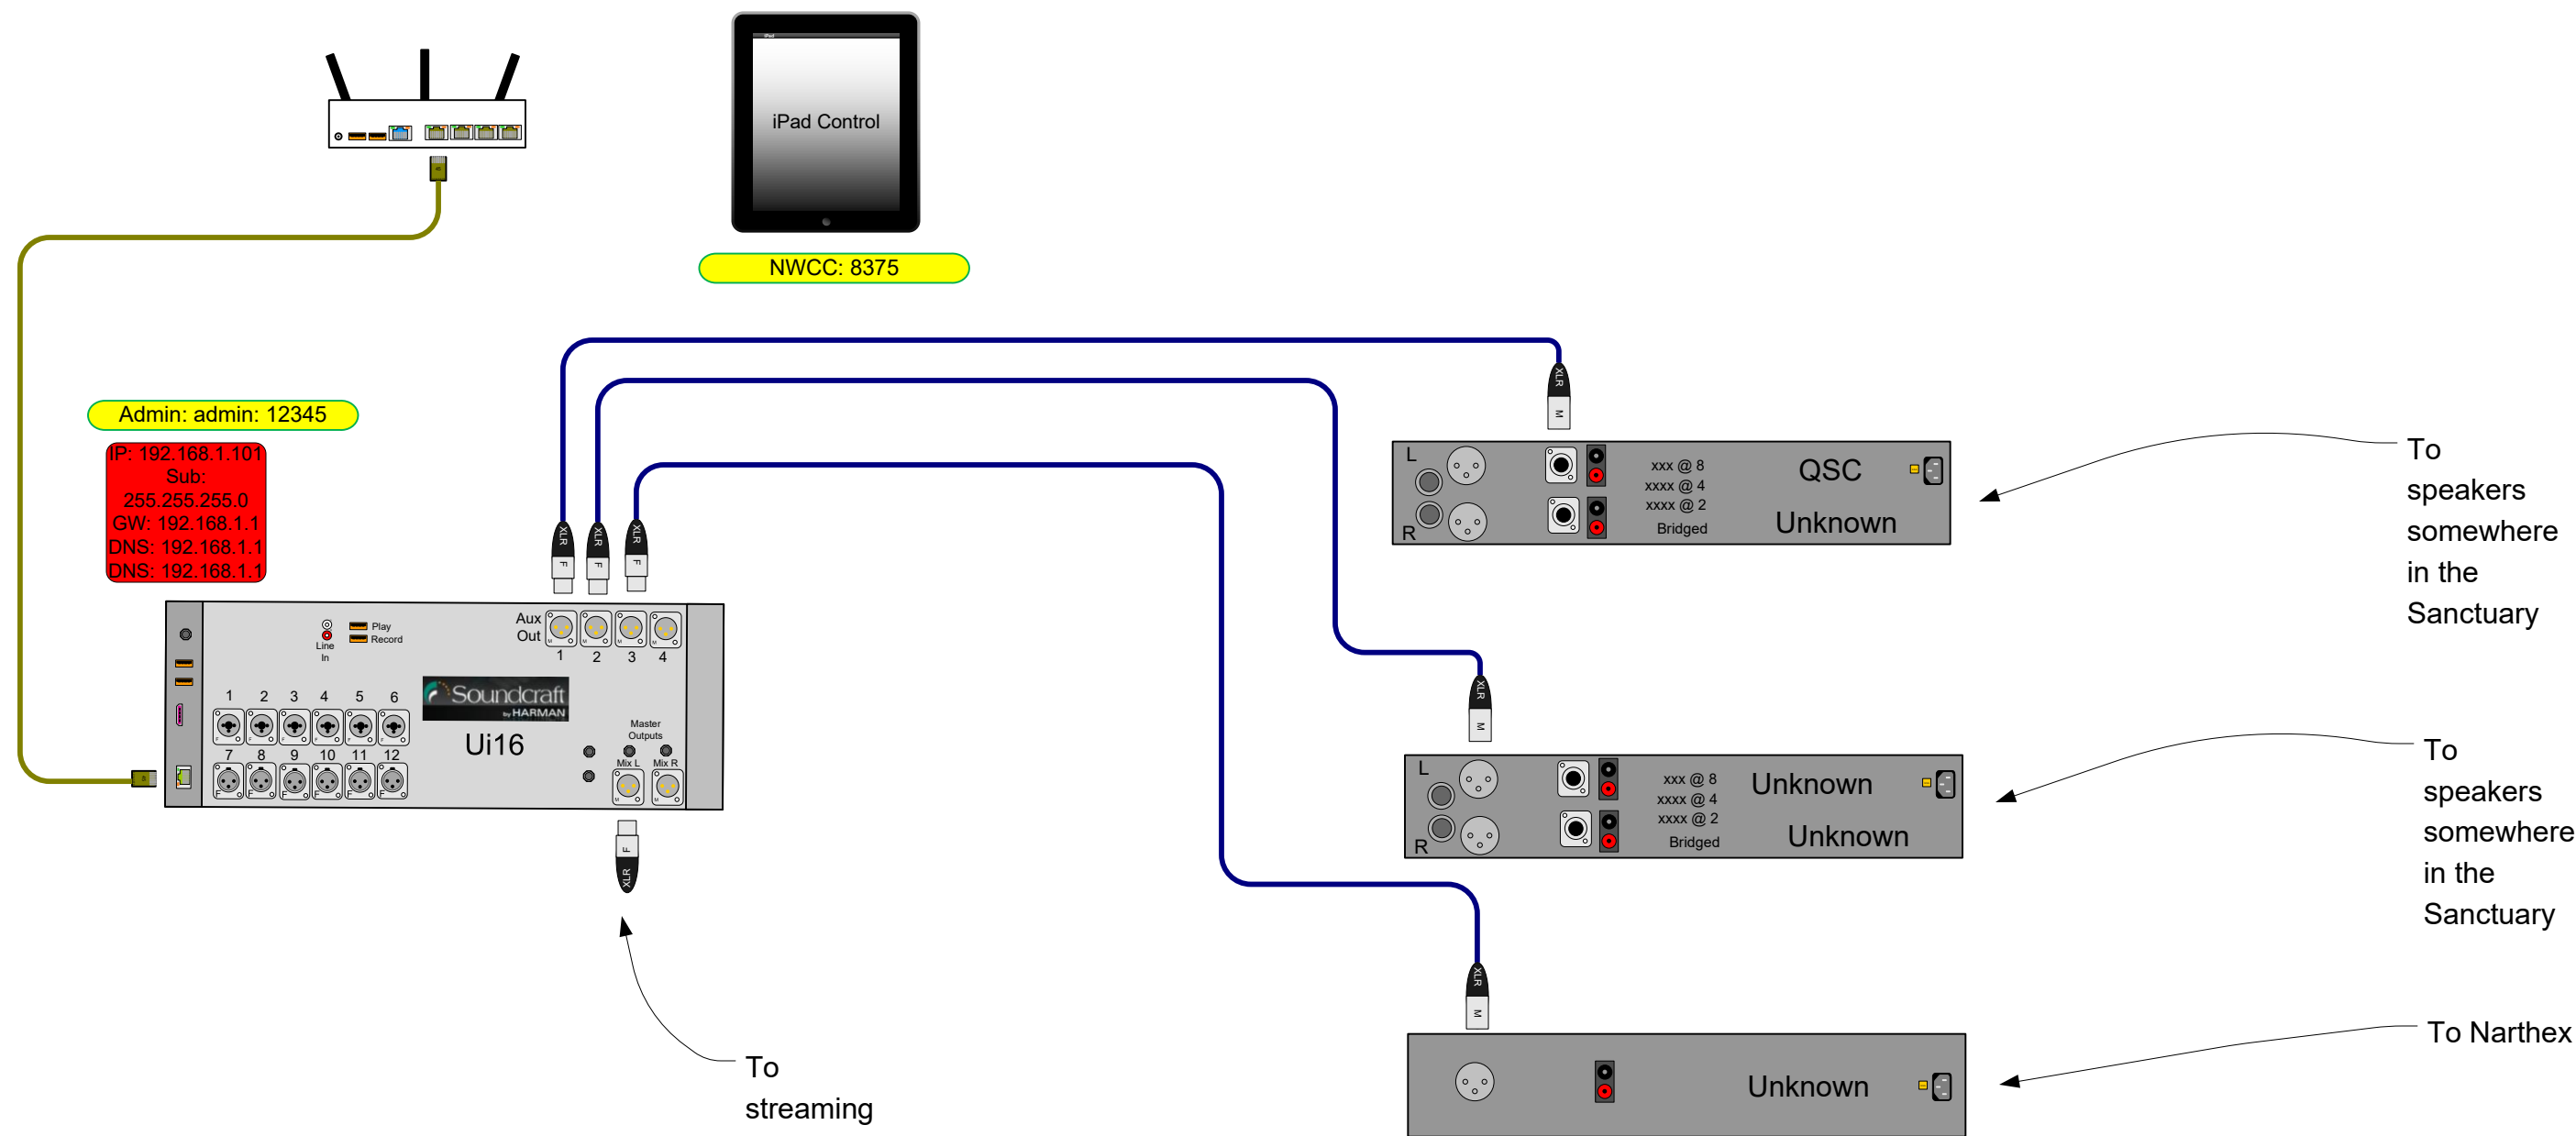

Proprietary & Confidential  
Property of Sound Concepts LLC  
Copyright 2025

CUSTOMER  
**Resounding Joy Church**

Address  
**Audio As Built**

Proj #	Dwg #
Date	Revision
12-9-25	0
DRAWN BY	PAGE
J Murphy	1 OF 1