

SOUND CONCEPTS LLC

1233 Castle Dr. Ste A5 Mason, Oh 45040
 513-703-0147
 customerservice@soundconceptsllc.com
 www.soundconceptsllc.com

Wire Color Legend

Black	AC	AC Line
Blue	B	Audio, Balanced
Purple	U	Audio, Unbalanced
Yellow	V	Composite
Green	SV	S-Video
Brown	S	Speaker
Olive	E	Data
Light Green		Ground Circuit
Blue	VG	RGBHV
Red	RG	RGB
Purple	C	Co-Ax
Red	DC	DC Power
Green	CO	Serial
Cyan	CN	Cresnet
Orange	US	USB
Purple	QM	Quick Media
Light Green	DM	Digital Media
Orange	F	Fiber
Purple	H	HDMI - DVI
Black	A	As Marked

Proprietary & Confidential
 Property of Sound Concepts LLC
 Copyright 2017

CUSTOMER		St John the Baptist	
PROJECT		Sanctuary A/V	
Proj #	Dwg #	50722	50722-SAB
Date	Revision	12-14-17	1
DRAWN BY	PAGE	J Murphy	1 OF 3

SOUND CONCEPTS LLC


1233 Castle Dr. Ste A5 Mason, Oh 45040
 513-703-0147
 customerservice@soundconceptsllc.com
 www.soundconceptsllc.com

Wire Color Legend

Black	AC	AC Line
Blue	B	Audio, Balanced
Magenta	U	Audio, Unbalanced
Yellow	V	Composite
Green	SV	S-Video
Brown	S	Speaker
Olive	E	Data
Light Green		Ground Circuit
Blue	VG	RGBHV
Red	RG	RGB
Purple	C	Co-Ax
Red	DC	DC Power
Green	CO	Serial
Cyan	CN	Cresnet
Orange	US	USB
Purple	QM	Quick Media
Light Green	DM	Digital Media
Orange	F	Fiber
Magenta	H	HDMI - DVI
Grey	A	As Marked

Proprietary & Confidential
 Property of Sound Concepts LLC
 Copyright 2017

CUSTOMER	
St John the Baptist	
PROJECT	
Choir Mix Station	
Proj #	Dwg #
50722	50722-CMS
Date	Revision
5-31-17	0
DRAWN BY	PAGE
J Murphy	2 OF 3

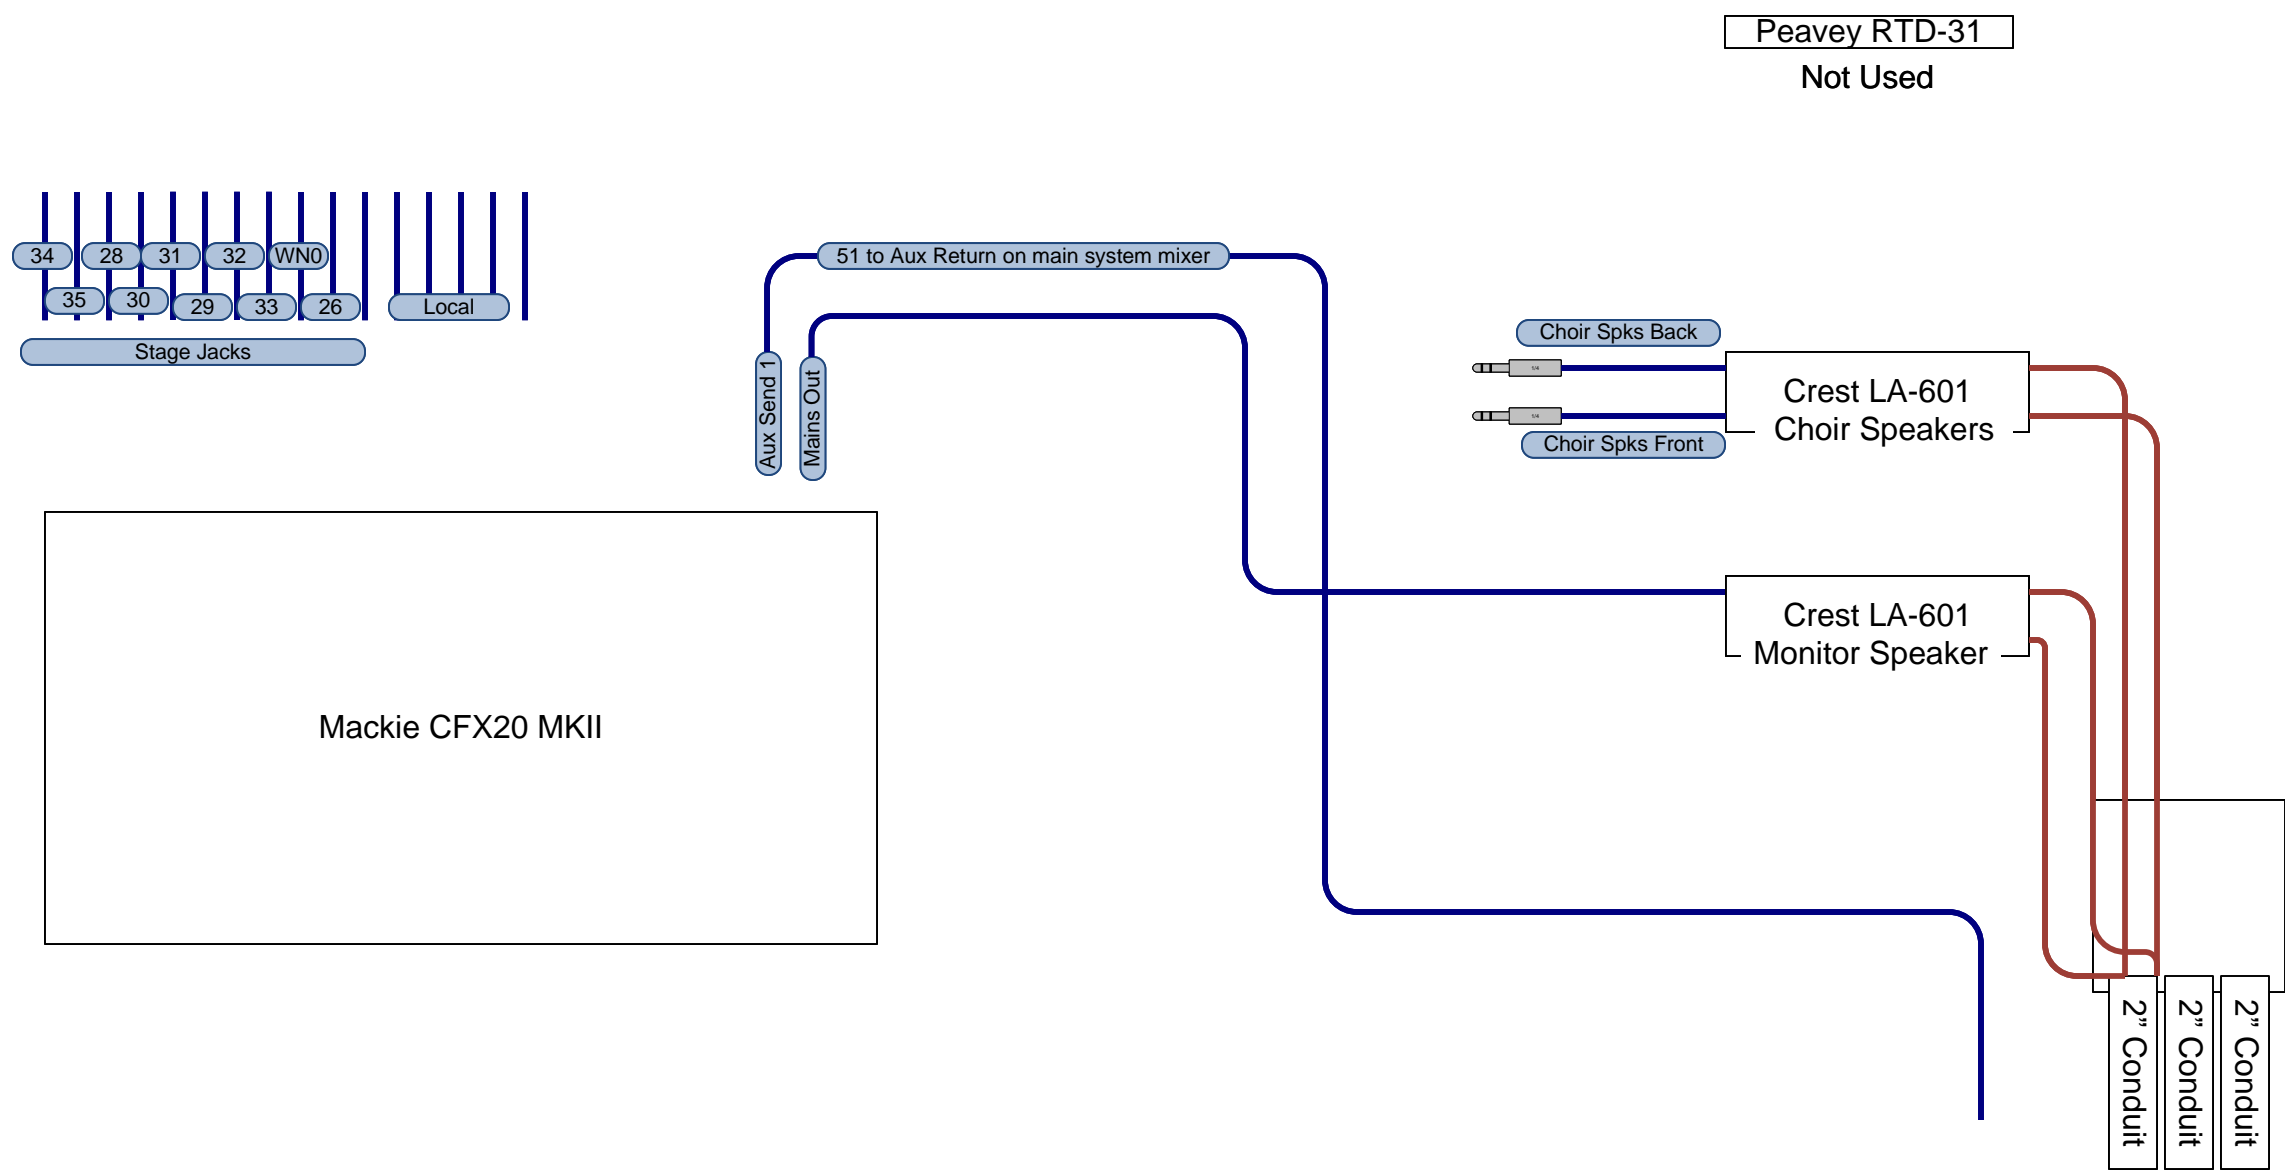

Mackie CFX20 MKII

Peavey RTD-31
 Not Used

51 to Aux Return on main system mixer


Aux Send 1
 Mains Out

Choir Spks Back
 Choir Spks Front

Crest LA-601
 Choir Speakers

Crest LA-601
 Monitor Speaker

2" Conduit
 2" Conduit
 2" Conduit

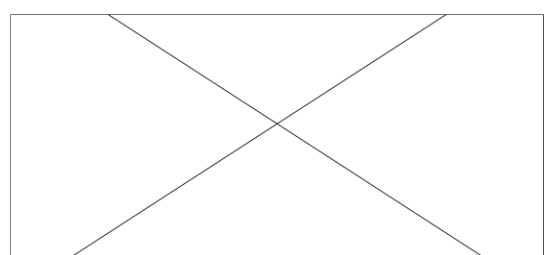


SOUND CONCEPTS LLC

1233 Castle Dr. Ste A5 Mason, Oh 45040
513-703-0147
customerservice@soundconceptsllc.com
www.soundconceptsllc.com

Wire Color Legend

AC	AC Line
B	Audio, Balanced
U	Audio, Unbalanced
V	Composite
SV	S-Video
E	Speaker
S	Data
Ground	Ground Circuit
VG	RGBHV
RG	RGB
C	Co-Ax
DC	DC Power
CO	Serial
CN	Cresnet
US	USB
QM	Quick Media
DM	Digital Media
F	Fiber
H	HDMI - DVI
A	As Marked

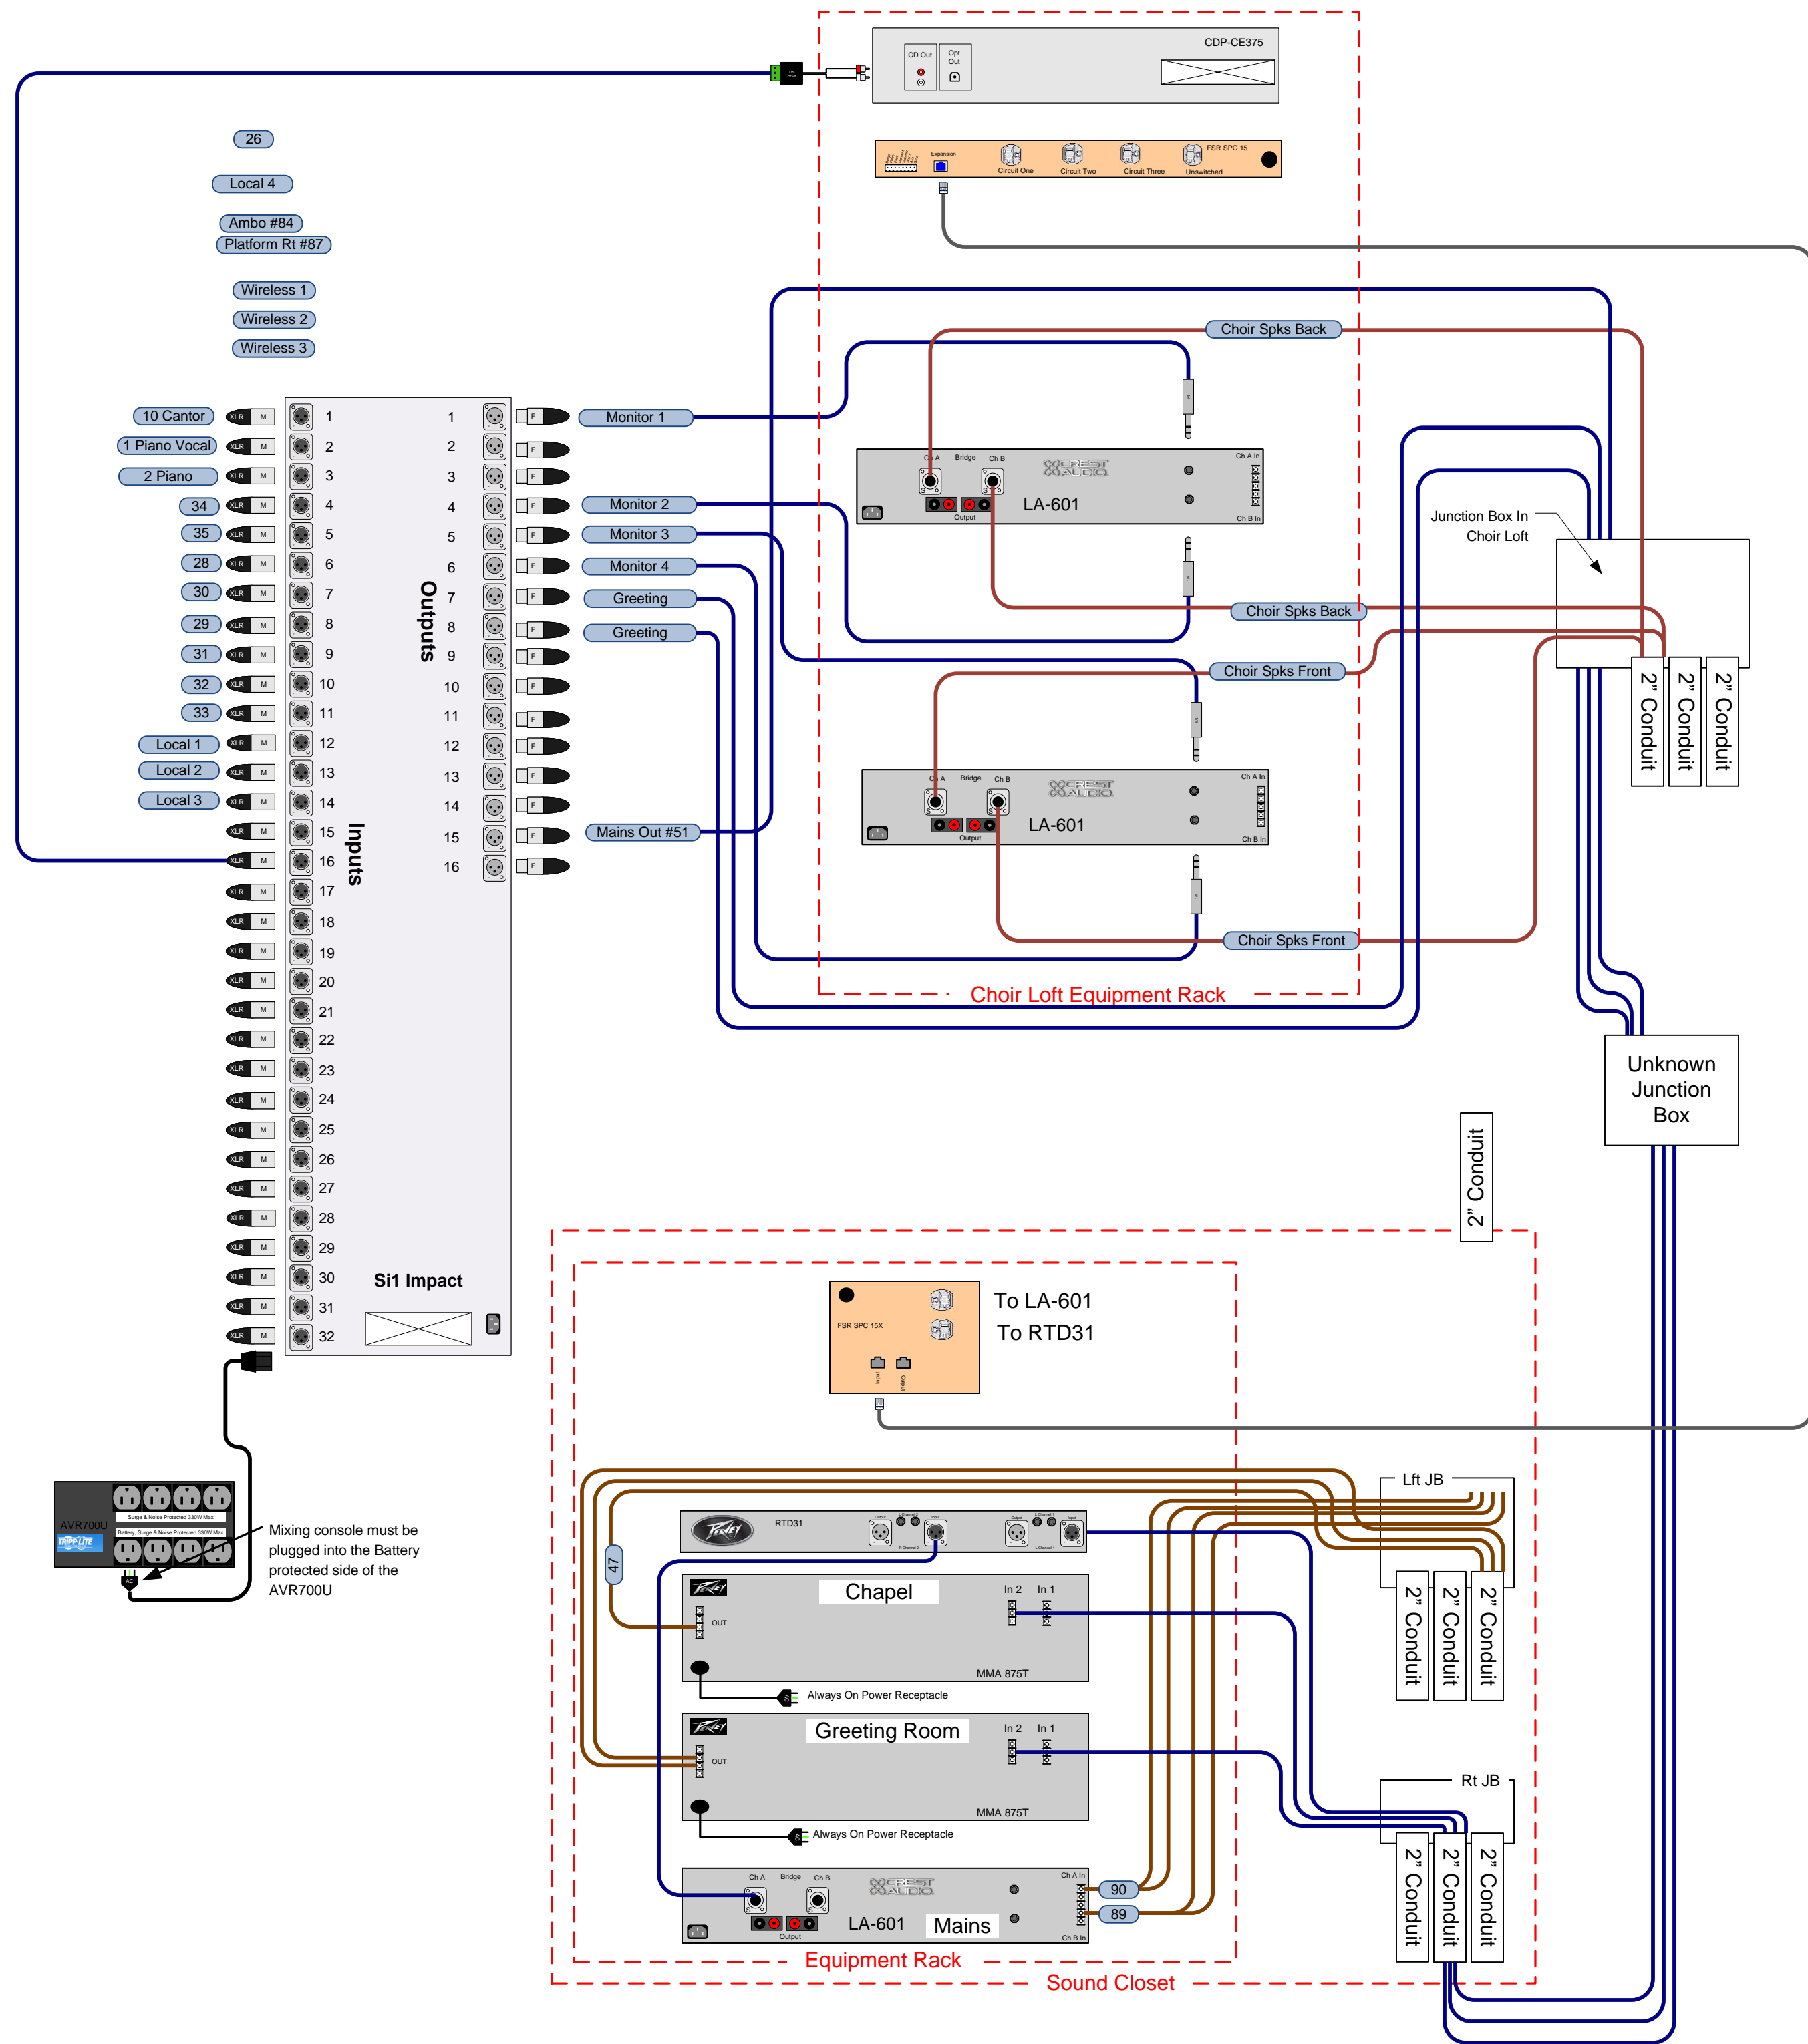

- Entrance #48
- Cafeteria #16
- Altar #85
- Parish #17
- Chapel #50
- Greeting #49
- Chair #17
- Platform Left #88
- Currently Unused 1
- Currently Unused 2
- Currently Unused 3
- Currently Unused 4
- Currently Unused 5

AVR700U
 Mixing console must be plugged into the Battery protected side of the AVR700U

Proprietary & Confidential
 Property of Sound Concepts LLC
 Copyright 2018

CUSTOMER	
St John the Baptist	
PROJECT	
Sanctuary Mixer	
Proj #	Dwg #
50722	50722-MS
Date	Revision
1-12-18	1
DRAWN BY	PAGE
J Murphy	3 OF 3