
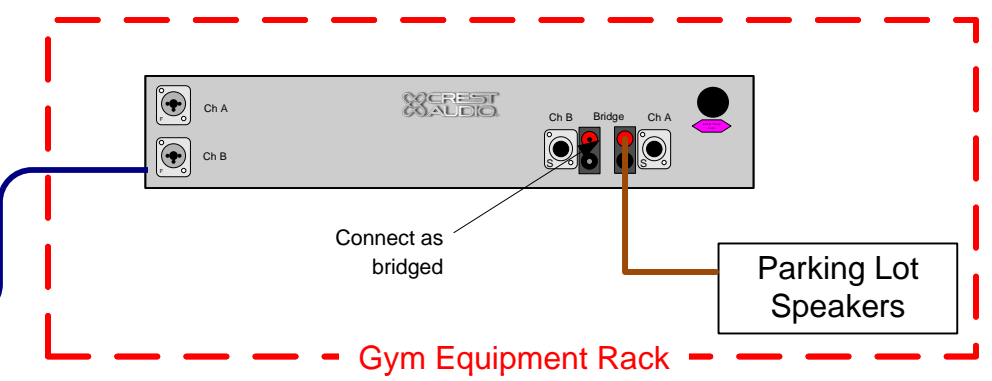


All devices must be connected to the grounding bar.

- Paging number assignments
- Port 1: XXX All Call
 - Port 2: XXX Announcer
 - Port 3: XXX Bells
 - Port 4: 307 Gym
 - Port 5: 308 Outside
 - Port 6: 309 Parish House
 - Port 7: 310

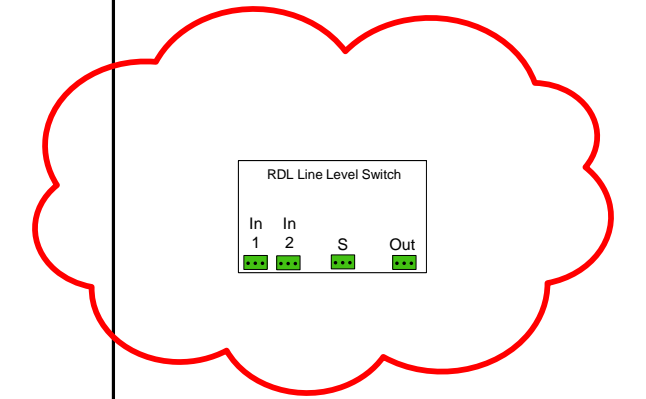

SOUND CONCEPTS LLC
 1233 Castle Dr. Ste A5 Mason, Oh 45040
 513-703-0147
 customerservice@soundconceptsllc.com
 www.soundconceptsllc.com

One line diagram except as shown in block with blue dashed line.

X Connection detail shown inside block.

Wire Color Legend

AC	AC Line
B	Audio, Balanced
U	Audio, Unbalanced
S	Speaker
DA	Digital Audio
E	Data
Ground	Ground Circuit
BL	BLU Link
C	Co-Ax
DC	DC Power
CO	Serial
DM	Digital Media 8G
F	Fiber
H	HDMI - DVI
A	As Marked

Room Numbers Not Detailed on This Drawing

Proprietary & Confidential
 Property of Sound Concepts LLC
 Copyright 2020

CUSTOMER	
St John The Baptist School	
Address	
5375 Dry Ridge Road, Cincinnati, Oh 45252	
PROJECT	
Paging/Bell System	
Proj #	Draw #
50831	50831-S
Date	Revision
10-27-2020	3
DRAWN BY	PAGE
J Murphy	1 OF 1