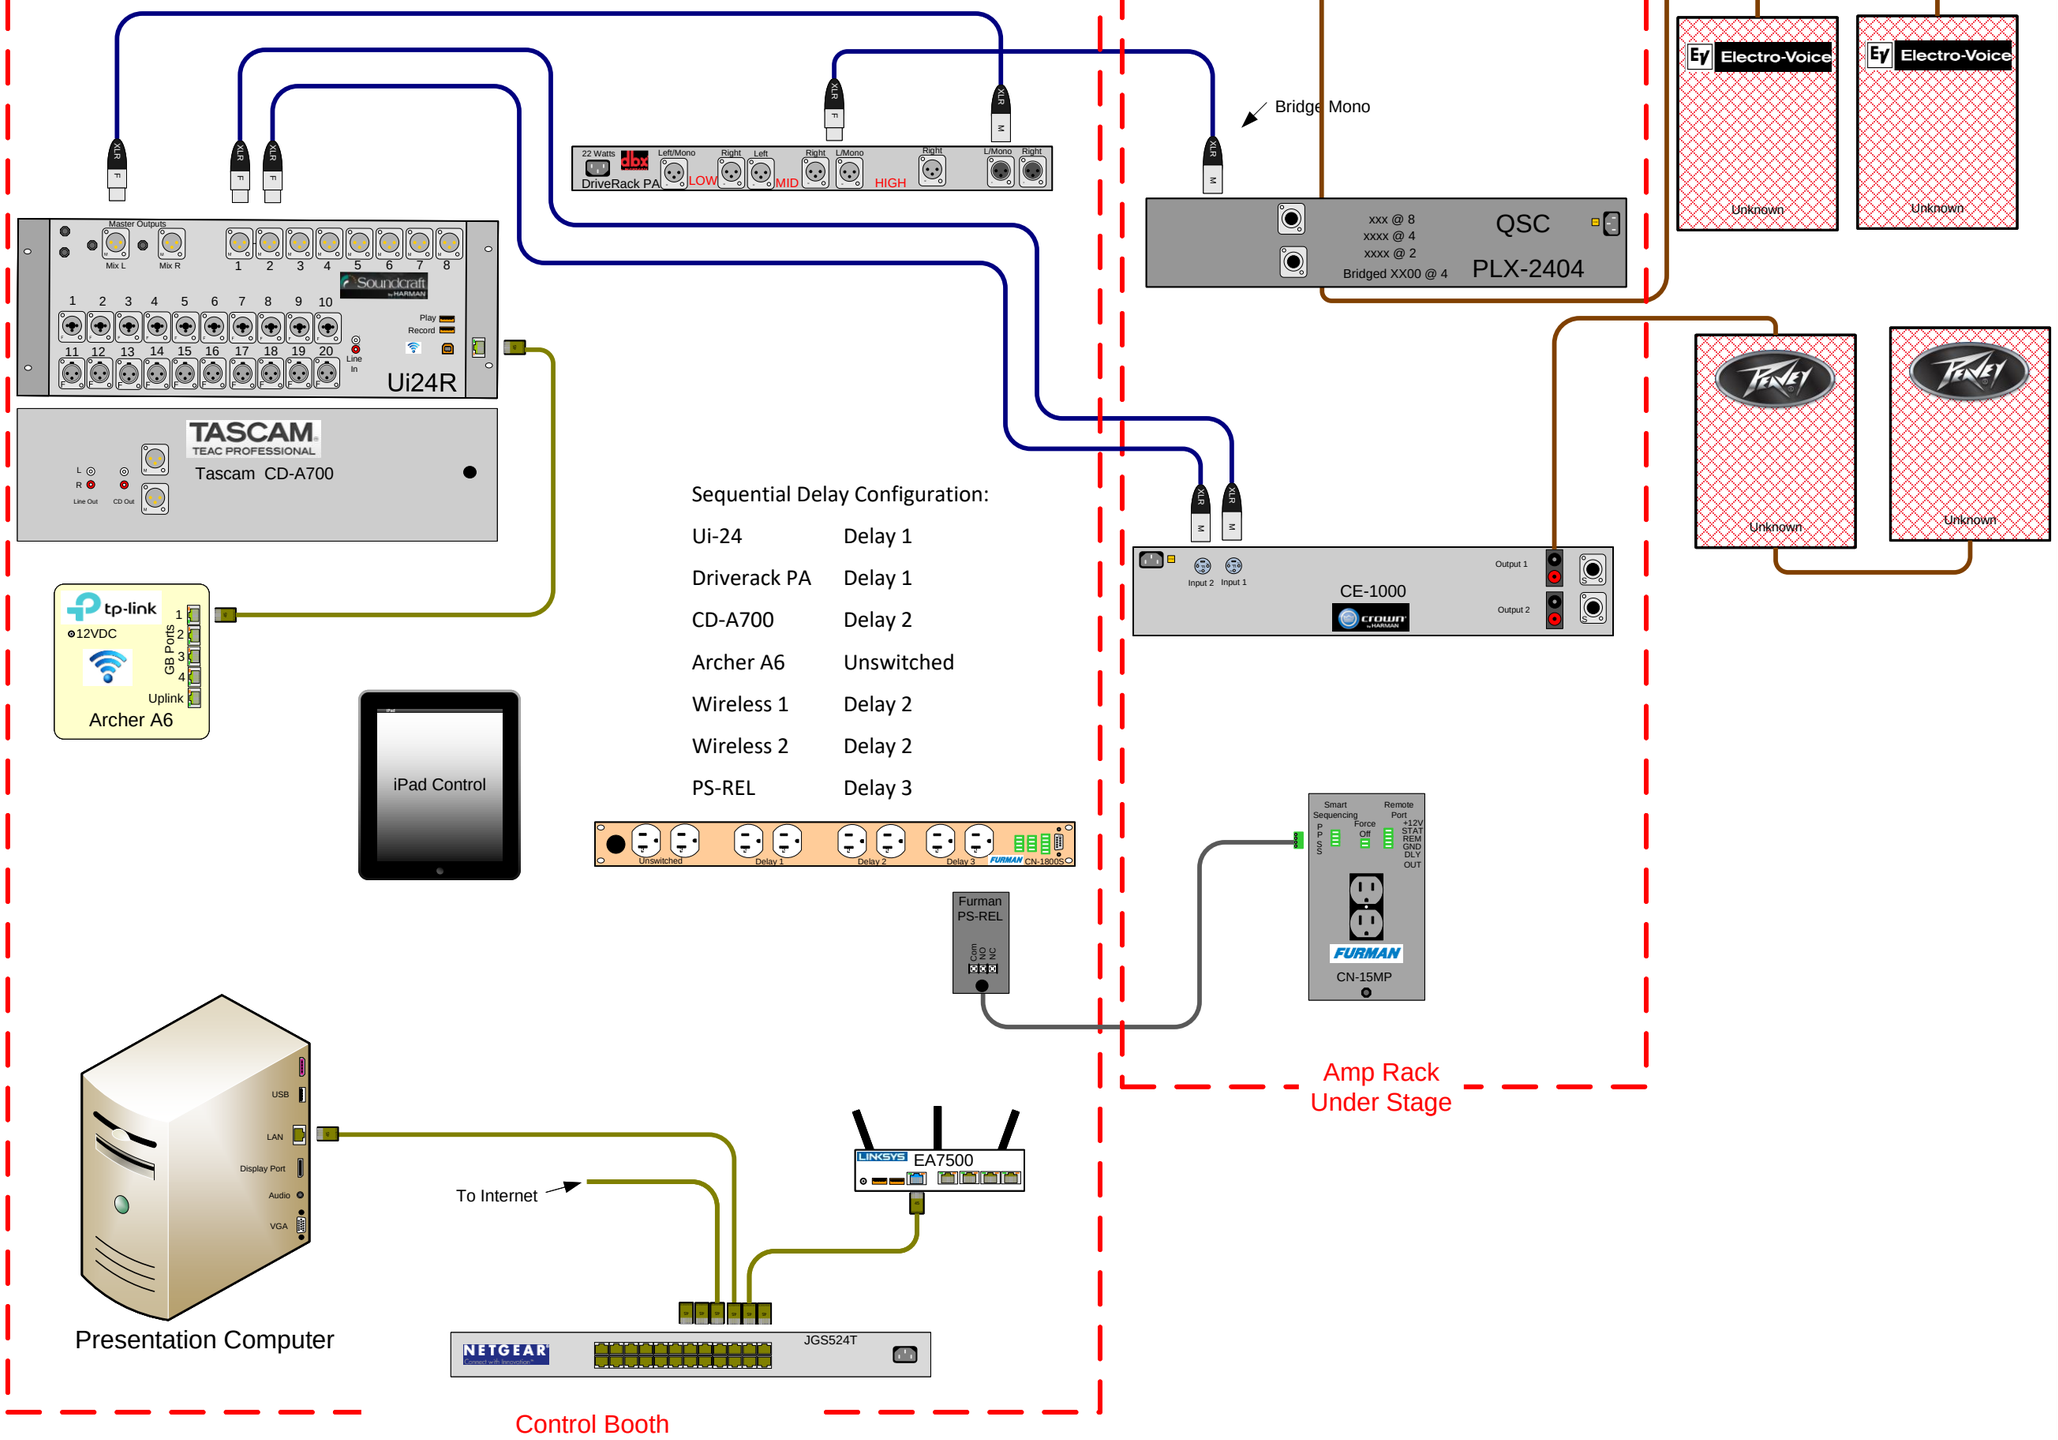

SOUND CONCEPTS LLC
1233 Castle Dr. Ste A5 Mason, Oh 45040
513-703-0147
customerservice@soundconceptsllc.com
www.soundconceptsllc.com

Wire Color Legend

	AC	AC Line
	B	Audio, Balanced
	U	Audio, Unbalanced
	S	Speaker
	DA	Digital Audio
	E	Data
	DS	Data Shielded
		Ground Circuit
	BL	BLU Link
	C	Co-Ax
	DC	DC Power
	CO	Serial
	U	USB
	F	Fiber
	H	HDMI - DVI
	HD	As Marked
	A	As Marked

Proprietary & Confidential
Property of Sound Concepts LLC
Copyright 2022

CUSTOMER
Beacon of Christ

Address

PROJECT
Audio System

Proj #	Dwg #
50937	50937-C
Date	Revision
3-16-2022	1
DRAWN BY	PAGE
J Murphy	1 OF 1