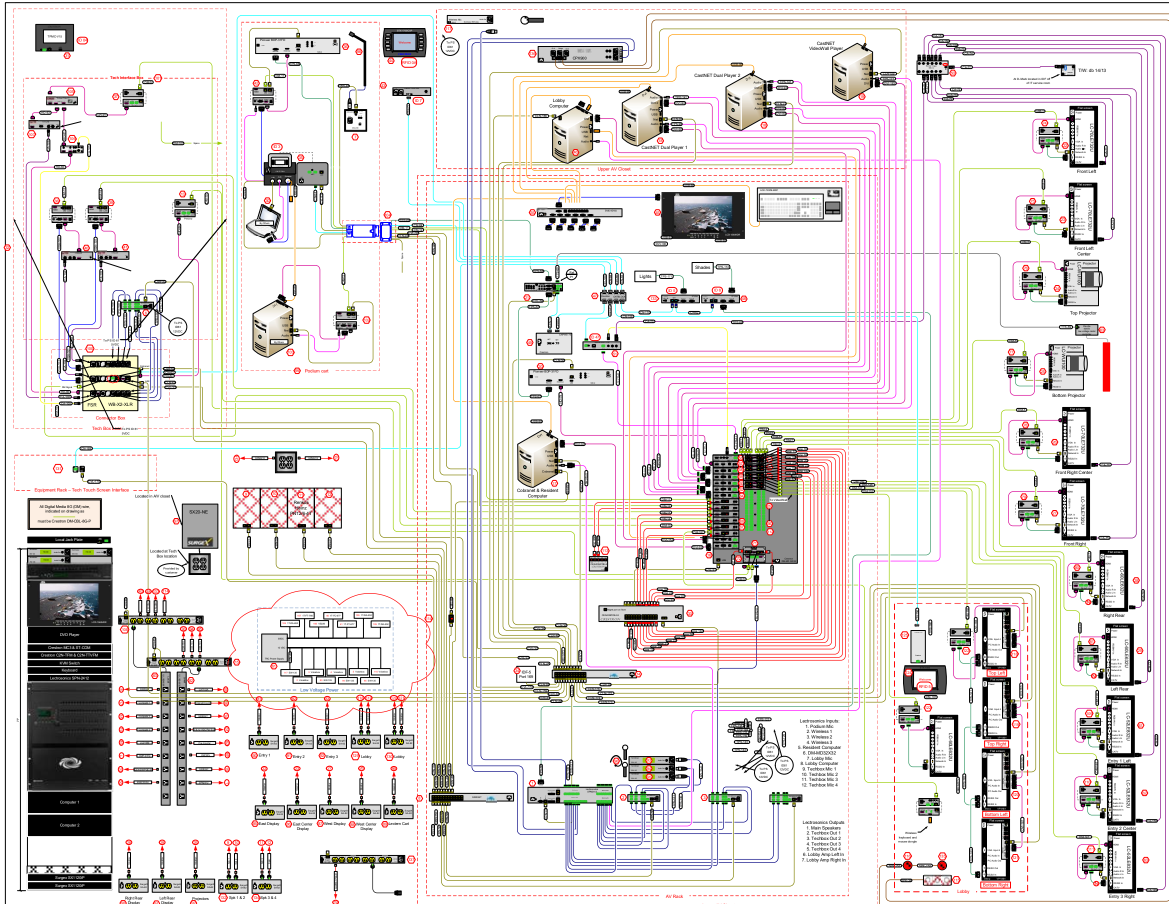

SOUND CONCEPTS LLC

1233 Castle Dr. Mason, Oh 45040
513-573-9006
customerservice@soundconceptsllc.com
www.soundconceptsllc.com

Wire Color Legend

- AC Line
- Audio, Balanced
- Audio, Unbalanced
- Composite Cable
- S-Video
- Speaker Cable
- Data Cable
- Ground Circuit
- RGBHV Cable
- RGB Cable
- Co-Ax Cable
- DC Power Cable
- Serial Cable
- Crestnet
- USB
- Quick Media
- Digital Media 8G
- Fiber
- HDMI - DVI
- As Marked

N — Indicates Null Modem Cable

ID XX — Crestnet ID #

0 — Item ID#

NP — No Power

Note: All stereo audio runs shown as a single wire. Except for Mics all wires are 2 channel but drawn as only one.

Rev 4: Added Videowall

Rev 8: Show speaker power
Show Tech Location Power

Rev 9: Add Spk pwr Conditioning.

Rev 10: Add Resident Computer for Videowall

Rev 11: Update wire numbers and other as-built changes

Rev 12: Update wire numbers and other as-built changes

Rev 13: Added Upper Closet Designation

Proprietary & Confidential
Property of Sound Concepts LLC
Copyright 2011

Construction Drawing

CUSTOMER	Great Oaks
PROJECT	Diamond Commissary & VideoWall
Proj #	50235
DATE	9-19-11
Revision	CR14
DRAWN BY	J Murphy
PAGE	1 OF 3